


REV. ZONE	DESCRIPTION	DATE	APPROVED

REVISIONS

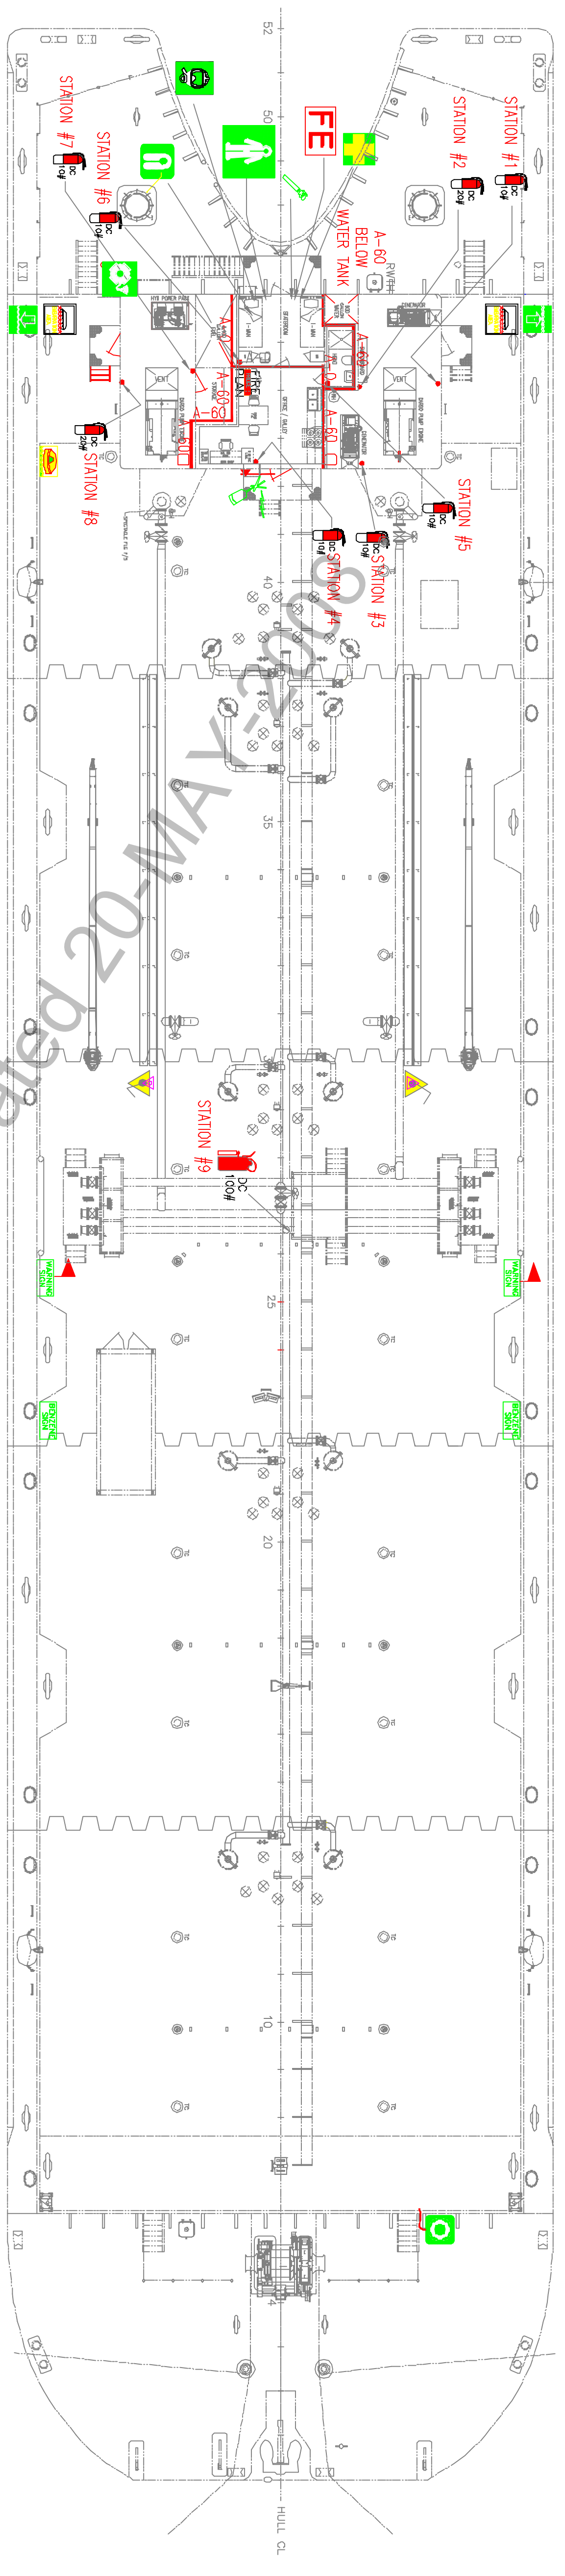


SYMBOLS LEGEND

SYMBOL	ITEM	QTY.	DESCRIPTION	REMARKS
	1	6/6	PORTABLE FIRE EXTINGUISHER: ANSUL MODEL 10-E WITH MOUNTING BRACKET.	B/C-II CLASS 6 REQUIRED / 6 SPARES
	2	2/2	PORTABLE FIRE EXTINGUISHER: ANSUL MODEL 20-E WITH MOUNTING BRACKET.	B/C-III CLASS 2 REQUIRED / 2 SPARES
	3	1/1	STATIONARY FIRE EXTINGUISHER & ANSUL S-150-C DRX-CHEMICAL CARRY BAG, EOT.	BY CLASS 1 REQUIRED / 1 SPARE
	4	1	FIREMAN'S AXE	ONE W/LIGHT & NO ROPE ONE W/ROPE & NO LIGHT
	5	1/1	30" RING BUOYS, INTERNATIONAL--ORANGE COLOR, WITH 100 FEET OF 3/8" POLY-PROPYLENE, AND ONE ACR SM2 WATER LIGHT ATTACHED.	ONE W/LIGHT & NO ROPE ONE W/ROPE & NO LIGHT
	6	2	EXPOSURE/SURVIVAL SUIT, MANUFACTURED OF DOUBLE SIDE NYLON--LINED NEOPRENE, FIRE-RESISTANT, WITH LIGHT-REFLECTIVE TAPE, BACK-RESCUE HARNESS, FIVE-FINGER GLOVES, FLAME RESISTANT CARRY BAG, EOT.	SURVIVAL INTL. MODEL 316-SAV
	7	2	KAPOK LIFE JACKETS, WITH REFLECTIVE TAPE AND ONE ACR MODEL L-8-2 WATER LIGHT, ADULT TYPE	CG-500
	8	1	NEGATIVE LIFE RAFT FOR 6 MEN, UNLIMITED OCEAN SERVICE, CABLE OF AUTOMATIC INFLATION, PACKED INSIDE A WATERTIGHT CONTAINER AND MOUNTED IN A GRADLE WITH AUTOMATIC HYDROSTATIC RELEASE.	VIKING LIFE SAVING EQUIP.
	9	1	EPIRB - EMERGENCY POSITION INDICATING RADIO BEACON	SURVIVAR NO. 9838-20 SEE G.N. 1
	10	1	PRESSURE-DEMAND BREATHING APPARATUS: OPEN CIRCUIT COMPRESSED AIR TYPE UNIT, 30 MINUTES CAPACITY, WITH A SILICON RUBBER FACE PIECE, AND A CASE.	
	11	1	12 FLARES IN WATERTIGHT CONTAINER, MARK & PAINT IN BRIGHT COLORS	
	12	1	FIREMAN'S PROTECTIVE OUTFITS CONSISTING OF: 1 GEARBAG, 1 PAIR OF FIREMAN'S GLOVES & BOOTS, (KNEE HIGH) 1 RIGID HELMET W/IMPACT PROTECTION, 1 FLASHLIGHT TYPE II OR III ASTM F1014-1988 1 FIREMAN'S JACKET & PANTS, 1 SAFETY LINE.	
	13	1	FUEL LIGHT W/ROPT (MOUNT ON TOP OF HOUSE WHERE CAN BE SEEN)	
	14	1	FIRST AID KIT	
	15	2	USCG APPROV WARNING SIGN W/RED FLAG: "WARNING: DANGEROUS CARGO, NO SMOKING, NO OPEN LIGHTS, NO VISITORS"	ERL MDL. DCA-001 OR EQUAL
	16	2	EMERGENCY ENGINE SHUTDOWN	
	17	-	A-CLASS DIVISION	
	18	1	FIRE & SAFETY PLAN (PLASTICIZED & MOUNTED)	ALEXANDER/RYAN
	19	2	EMBARKATION/DEBARKATION LADDER	
	20	1	LINE THROWING APPLIANCE W/4 STRIKERS	SPEED LINE 250
	21	2	USCG APPROV WARNING SIGN: "DANGER: BENZENE, REGULATED AREA, CANCER CAUSING AGENT, FLAMMABLE, NO SMOKING, AUTHORIZED PERSONNEL ONLY, RESPIRATOR REQUIRED."	ERL MDL. BNZ-001 OR EQUAL

MAIN DECK

GENERAL NOTES

- SPARE CHARGES FOR BREATHING APPARATUS:
ONE (1) CYLINDER STD. 45 CU. FT. SURVIVAR #9151-45"
W/CGA THREADS, COMPLETE W/VALVE
- LIVING QUARTERS ARE FOR TWO PERSONS.

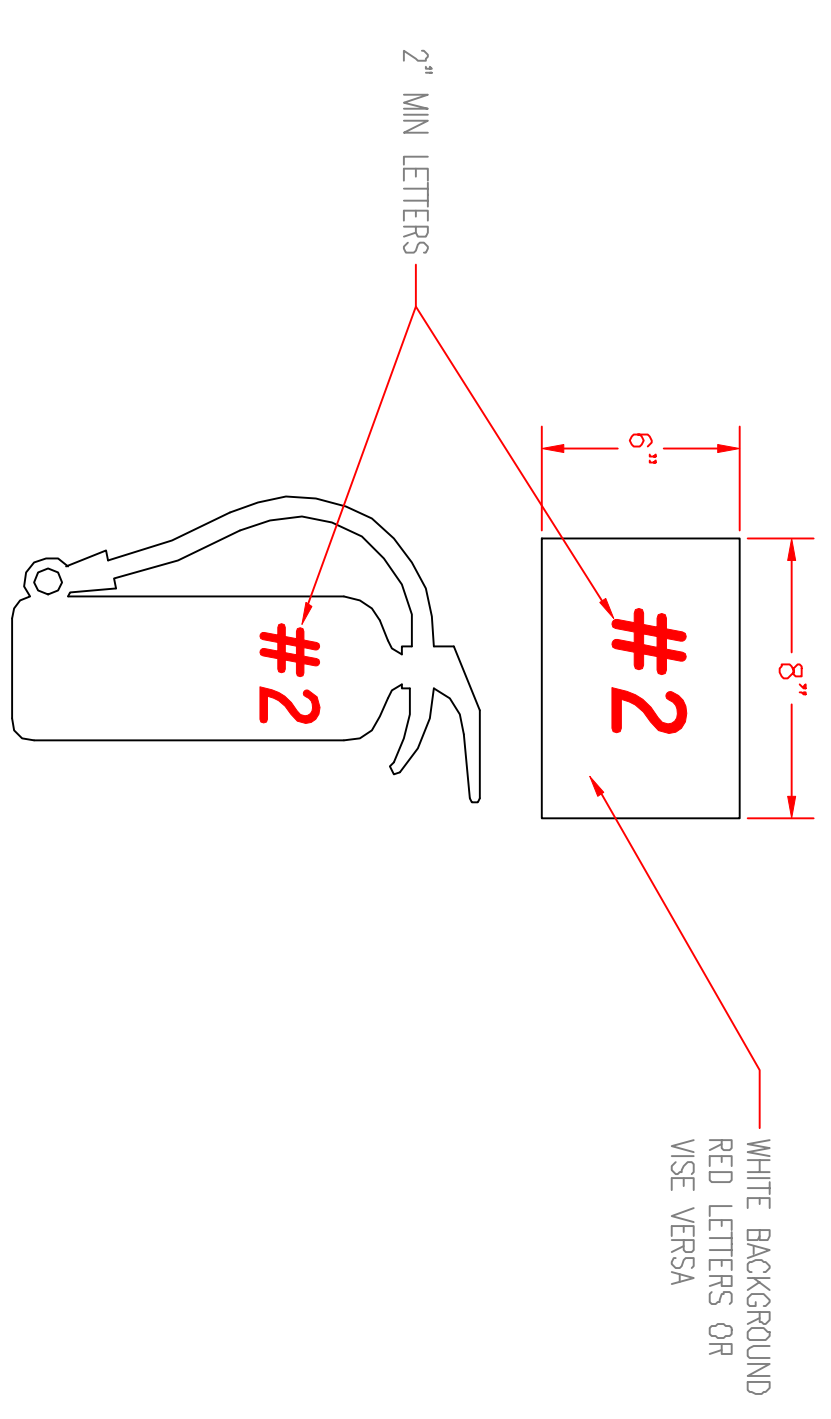

FIRE STATION DESIGNATION

TYPE: 9 STATIONS
SCALE: NONE

No reviewed for lifesaving appliances

APPROVED AS AMENDED
This approval covers only ABS requirements and does not include items not required by ABS. See comments in ABS letter.

ABS

ISSUED BY: _____

DATE IN ROOM: 4/29/08

REV # 0

OWNER (10)

PM (10)

PE (0)

USCG (0)

ABS - PG (10)

PLASD - PG (10)

HMP - PG (10)

FIRE & SAFETY PLAN

DESIGN NO.	DATE	ISSUED BY	APPROVED BY
M293	4/14/08	CSB/AB	F
SCALE	DATE	ISSUED BY	APPROVED BY
1/32" = 1'-0"	05-014	CSB/AB	F

VT Halter Marine, Inc.
332' x 74' x 25' DBL SKIN OIL TANK BARGE

VT Halter Marine, Inc.
332' x 74' x 25' DBL SKIN OIL TANK BARGE

VT Halter Marine, Inc.
332' x 74' x 25' DBL SKIN OIL TANK BARGE

VT Halter Marine, Inc.
332' x 74' x 25' DBL SKIN OIL TANK BARGE